


**As-Built Floor Plan**

Scale: N.T.S.

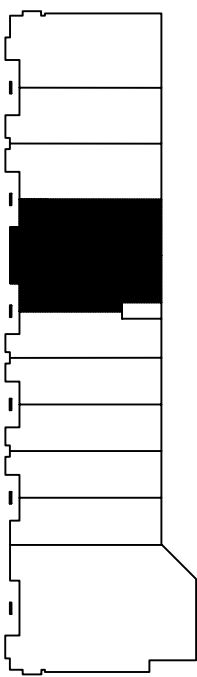

**As-Built Information**

Square Footage: ±3,092.2 R.S.F.  
 Field V. offset: Yes  
 ADA V. offset: Yes  
 Square Footage is based on BOMA methods of calculating square footage unless otherwise noted.

Completed By: B. Smith  
 Date Completed: 5-1-2010

**Carlsbad Commercial Center ~ Suite D & E  
 5205 Avenida Encinas, Carlsbad, CA 92008**

All information contained herein is from sources deemed reliable. No representation or warranty is made to the accuracy thereof.  
 All rights reserved. All drawings and written material contained herein constitute the original unpublished work of B. Smith  
 Design Associates and cannot be duplicated and/or disclosed without prior written consent.



**B A S M I T H D E S I G N A S S O C I A T E S**  
 interior design • spaceplanning • building development

1205 J street - suite l - san diego california 92101  
 phone 619.819.8720 fax 619.923.3218  
 info @ basmithdesigns . com