

CARLSBAD PACIFIC CENTER I


701 PALOMAR AIRPORT ROAD
CARLSBAD, CA 92008

JANUARY 8, 2014
SCALE: 1/8" = 1'-0"

UNIRE REAL ESTATE GROUP
701 PALOMAR AIRPORT RD., STE. 280
CARLSBAD, CA 92011 760-579-0144

SUITE 160
AS-BUILT PLAN

APPROX. 2,671 U.S.F.
APPROX. 2,952 R.S.F.

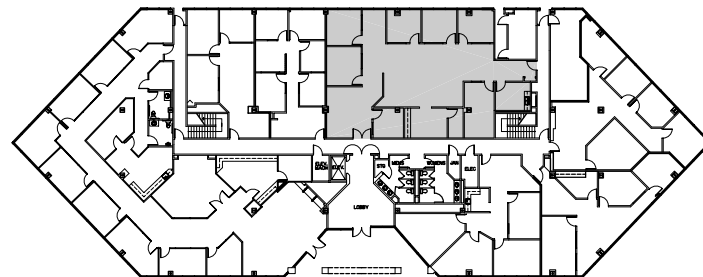

FIRST FLOOR

MAGGETTI ELAM ASSOCIATES
3160 CAMINO DEL RIO S., STE. 207
SAN DIEGO, CA 92108 619-624-0521