


As-Built Floor Plan

Scale: $\frac{1}{8}" = 1'-0"$

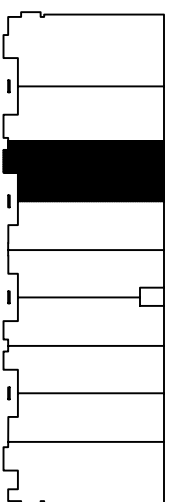

As-Built Information

Square Footage: ±1,572.8 R.S.F.
 Field Verified: Yes
 ADA Verified: Yes
 Completed By: B. Smith
 Date Completed: 5-1-2010
 Square Footage is based on BOMA methods of calculating square footage unless otherwise noted.

Carlsbad Commercial Center ~ Suite G 5245 Avenida Encinas, Carlsbad, CA 92008

All information contained herein is from sources deemed reliable. No representation or warranty is made in the accuracy thereof. All rights reserved. All drawings and written material contained herein constitute the original unpublished work of B.A. Smith Design. Associates and cannot be duplicated and or disclosed without prior written consent.

[bas]

B A S M I T H D E S I G N A S S O C I A T E S
 Interior design · spaceplanning · building development
 1205 J Street - Suite 1 - San Diego California 92101
 phone 619.819.8720 fax 619.923.3218
 info @ basmithdesigns . com